


VICTORIA HARBOUR

APPROX. LOCATION & SIZE OF PROTECTED SHIPWRECK

ACTUAL NEW REVETMENT AREA (964 m²)

PROPOSED NEW REVETMENT AREA (775 m²)

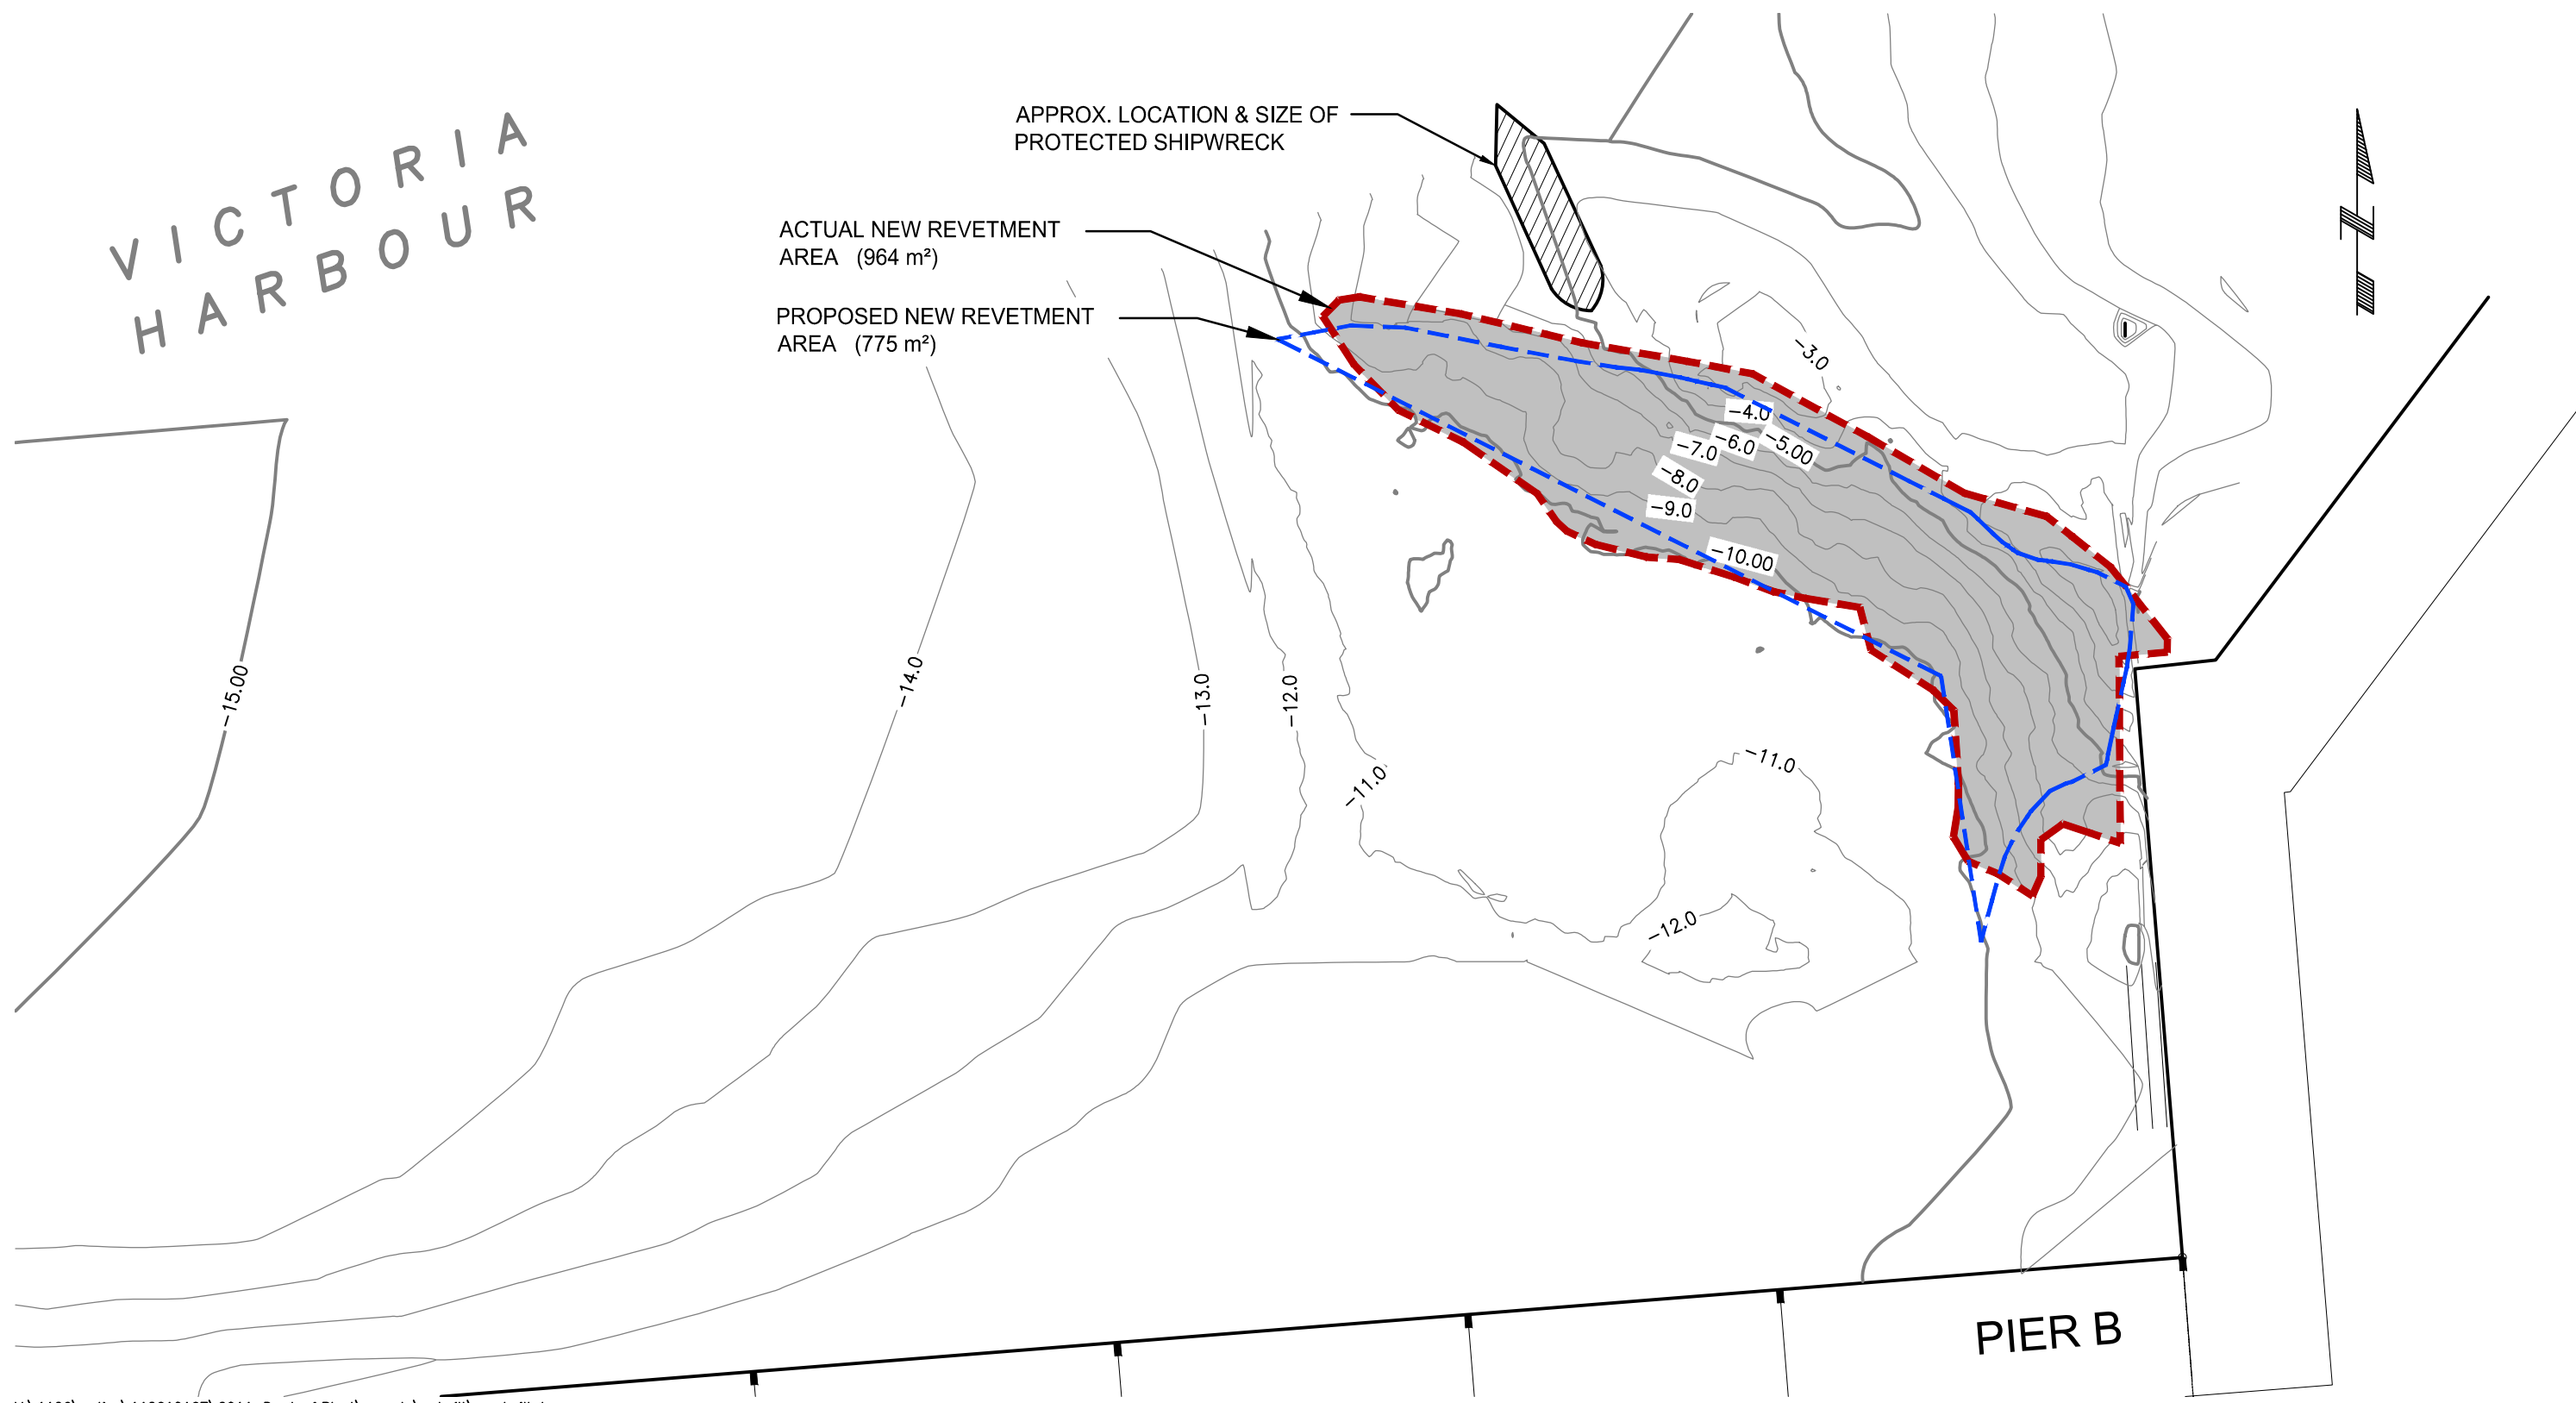

V:\1126\active\112610167\2011_Dredge&Blast\reports\asbuilt\as-built.dwg
3/29/2011 5:38 PM By: PMALLON

MARCH 29 2011
112610167

ORIGINAL SHEET - ANSI B



Stantec

Stantec Consulting Ltd.
400 - 655 Tye Road
Victoria BC Canada
V9A 6X5
Tel. 250.388.9161
Fax. 250.382.0514
www.stantec.com

Legend

Notes

1. CONTOURS PROVIDED BY TERRA REMOTE SENSING INC. BATHYMETRIC SURVEY, MARCH 4, 2011.
2. CONTOURS GIVEN IN METERS, RELATIVE TO CHART DATUM
3. OUTLINE OF ROCK-COVERED SEABED AREA PROVIDED BY TERRA REMOTE SENSING INC. SIDE-SCAN SONAR, MARCH 18, 2011.



Client/Project

GREATER VICTORIA HARBOUR AUTHORITY
OGDEN PT. PIER B BERTHING IMPROVEMENTS
Victoria, BC

Drawing No.
1.0

Title

AS-BUILT
DREDGED AREA PLAN